

LA9XFA

**T7F**

**70 cm FM FSK  
Transceiver Handbook**

Updated on November 16 1998

**Holger Eckardt  
DF2FQ**

**English translation :**

INFRACOM, 69 boulevard Albert 1<sup>er</sup>, F-44600 Saint Nazaire / France  
Tél : + (33) 2 40 70 97 68 // Fax : + (33) 2 40 70 98 30 // Email : [infracom@avo.net](mailto:infracom@avo.net)

## Technical specifications :

Misc.	
Frequency range	430,000 .. 440 MHz
Channel spacing	12.5 or 25 kHz
Tx/Rx switching time	<30ms
Temperature range	-5 .. +50°C
Power supply	7..14V, 60mA RX, max 2,5A TX
Dimensions	145 x 75 x 22 mm
Receiver	
Digital sensitivity	-120dBm (=0.22µV) with a BER < 10 <sup>-4</sup> (tested on a DF91C modem)
Analog sensitivity	-118dBm for 20dB SINAD (CCITT)
Frequency range	1Hz .. 7000Hz at -3dB
Intermodulation	-54dB (3 tones measurement)
Selectivity on neighbouring channels	>56dB
Harmonic attenuation	>60dB
Transmitter	
Output power	1.5W at 7V, 6.5W at 12V
Frequency range	1Hz .. 15000 Hz at -3dB
Klirrfaktor	<1.5%
Selectivity	-66dBc (1.0W), <-75dBc
Perturbation on neighbouring channels	< -40dB

## Controller :

It is here one of the most important part of the transceiver. We use a PIC microcontroller 16F83 from Microchip. It has 4 functions : watching the PTT line, programming the Tx and Rx frequencies, with or without frequency shift, and with a synchronization.

Above this, the user side is also under control : channel switching, entry of new frequencies, etc

## Assembly :

The whole module is to be mounted on a 72 x 144 mm board. See the placing of all components on drawing 5 and the part-list at the end of this manual. Please put a cross on the value each time you solder a component. This way, you won't forget any

The VMOS transistor <sup>T1</sup> (BS170) should be placed only when setup is done.

Place all components as close as possible to the PCB and cut all legs on the solder side. Don't use any IC holder, except for IC1.

On T5, the longest leg is the *Drain*, and *Collector* on T6. D2 (BB405) has no printing on it but has a black body and a white ring.

Unfortunately, Q2 legs don't have the right spacing : mount it carefully.

You'll have to make 4 coils by yourself. They are identified 3W3D on the drawing : 3 turns on a 3 mm diameter. Use copper wire of 0.4 mm and wind it on a 3 mm drill. Scratch the protective varnish near the soldering points.

Attention : the color code of L14 (3.3µH orange orange gold) is very similar to the one of 0.33µH coils (orange orange silver). 0.1 µH coils (brown black silver) are also close to 1 µH (brown black gold).

The PA module is the only component to be mounted on the solder side of the PCB, its heatsink (the aluminium plate) has the PCB in its back. The module has to be fixed on the aluminium plate with a 4 mm spacing between the plate and the PA pins, using two 4 mm nuts.

Once the board assembled, place it in the enclosure by gathering and soldering both aluminium corners. Separating nuts are then put in place. The 5 mm long nuts go through both central holes, two more 4 mm pieces are placed between the PA module pins and the board.

Screw up everything in the box, then solder the PCB edge to the enclosure.

From outside the box, insert the BNC plug and the by-pass capacitor (power supply); solder them.

## Tuning :

Your I7F has 9 tuning steps. It may look a lot, but it's easier to reach your goal. You'll need the following equipments :

- Digital voltmeter
- Frequency meter (30 MHz minimum) with an accurate time base
- Oscilloscope (5 MHz is enough)
- A 500 Hz generator with a 500mV output : sinus and square signals
- A capacitance meter
- A steady 70 cm signal, modulated if possible with a level between -60 et -90 dBm (if you don't have this, a 0.5 Watt handy placed 30 m away should do the job !!)

First connect the power supply : 7 to 12 V<sub>pp</sub>. If the board has no short-circuit, you'll notice a current flow of about 60 mA. After two minutes heating up, connect the frequency meter on IC3 (MC3371), pin 2 : you should then read 20 950 MHz. Use R4 to adjust this frequency : please be accurate since this is the reference, multiplied 20 times to get the final frequency. One Hertz difference means 20 Hz drift !

Now let's program 430.000 MHz (see the Frequency Tuning chapter). Turn L1 until you have 0.8 V on the "cold" side of L3, while receiving

Now, set a frequency in the middle of the band, on 435 MHz for example. This frequency must be the one sent by the generator, your handy, or the local repeater. Connect the digital voltmeter to the RSSI output and set R53 (DCD) on its middle position. With no signal, you should read from 0.4 to 0.8 V. This value increases according to the strength of the received signal. Turn L6 and L7 in order to read the highest value. When the output is above -60 dBm (RSSI of about 3.5 V), don't expect to go further : you'll have to lower the signal before going on with your tuning. If you have no generator, a non-modulated carrier should be enough.

Connect a sinus generator to the modulation input (see drawing 7) and set it to 300 mV. Important : do NOT solder I11 because this transistor cuts the modulation input when the transceiver receives. You should read about 1 V<sub>pp</sub> on the NF-OUT (AF-OUT) pin. Use L9 to increase the signal and C70 to get a perfect sinusoidal shape. If you use a double trace oscilloscope, you'll have a perfect look at both signals, using both channels.

Let's now see to the transmitter. Switch your signal generator to the "square" shape and connect your oscilloscope to NF-OUT. The non-modulated carrier should always arrive to the receiver. Turn R41 until the signal has a square shape and about 1 V<sub>pp</sub> amplitude. Set the maximum level with L9 then with C70 (don't use metallic tools !), and try to have a nice sinusoid. Using a double trace oscilloscope could help a lot : one channel to the generator output, the second channel to the NF-OUTPUT.

Finally, solder I11

*500 Hz 300 mV pp*

## The user interface :

I7F has two headers, one next to the antenna, the second one next to the power supply. One has 10 pins (X2), the other one 14 pins (X1), with the following pinout :

X1				X2			
1	D0 } LSB	2	n.c.	1	GND	2	+5V
3	D1 } BCD	4	n.c.	3	DCD	4	PTI
5	D2 } BCD	6	n.c.	5	GND	6	MOD
7	D3 } MSB	8	TXD	7	GND	8	Sortie BF AF utgans
9	n.c.	10	RXD	9	n.c.	10	RSSI
11	PTI	12	12.5 / 25 kHz				
13	GND	14	+5V				

Use a flat cable on an HE10 connector to get all signals. X1 is used to change the frequency, along with a BCD switch, and to communicate with the computer's terminal. X2 is used to connect to the modem.

To locate Pin 1 on X1 and X2, place the PCB on your table : it's the upper right


*with BNC away from you*

## Frequency tuning :

Software version 1.4 can now use a 25 or 12.5 kHz channel spacing. Tx/Rx switching times are more important with the 12.5 kHz mode. Connect pin 12 to +5 V for 12 kHz, and to 0 V for 25 kHz. NEVER LET THIS PIN WITHOUT CONNECTION !!

As described in the technical presentation, I7F covers the whole 70 cm band, from 430 to 440 MHz. You can use any shift you want or simply work simplex. 10 channels are available, with separate Tx and Rx frequencies. To select a channel, use a BCD code on pins D0 to D3 (X1 connector). D0 is the less significant byte (LSB), D3 the most significant one (MSB). If you don't connect D0 to D3, you'll use channel 0.

All PICs are programmed with 430 MHz on channel 0, 431 MHz on channel 1, etc., 439 MHz on channel 9, with 25 kHz spacing

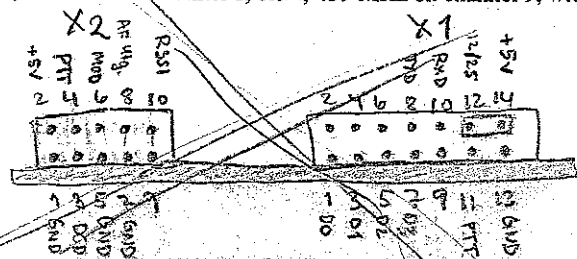

program your working frequencies, connect T7F to your computer :

COM port	T7F
TXD	RXD (pin 8)
RXD	TXD (pin 10)
GND	GND

*bits* *bit*

Set your terminal software to 1200 Baud, 8 bytes, no parity, 1 stop byte and use the following syntax :

Cntttrrr[RETURN]

C is the capital "C" (HEX 43), n the channel number (0 to 9), rrr the RX channel and ttt the IX channel.

Numbers given by rrr and ttt are calculated as follow :

$$N = (F - 430000) / R$$

R = channel spacing (12.5 or 25)

N = channel number, corresponding to the frequency

F = working frequency, given in MHz

$$N = \frac{430000 - 430000}{25} = 0$$

$$= \frac{434000 - 430000}{25} = \frac{4000}{25}$$

End the programmation with RETURN. It is not possible to edit a line : if you make a mistake, press RETURN and type the line again.

Here is an example :

You need Rx 438 100 MHz and IX 430 500 MHz on channel 0, then type :: C0020324

You need Rx 434 125 MHz and IX 434 125 MHz on channel 8, then type :: C8165165

*120*  
*25*  
*25*

Each letter typed is sent back by your T7F to control the link

Use "E" (Hex 45) to display the PIC's memory : all channels are displayed, programmed or not, in hexadecimal

### Available signals :

AF input and output are compatible with all modern modems. With a 3 kHz deviation, you'll get 1 Vpp on the receiver. On the transmitter, 300 mVpp are needed to obtain a 3 kHz deviation. Most of the modem we tested still activate their AF output when they receive. Therefore, we added a transistor to stop this signal on T7F's input.

T7F has a fast DCD (pin 3), linked to the RSSI voltage. When a signal arrives on the input (trigger to be tuned with R53), this voltage varies from 0 to 5 V. If you turn the trimmer to the link, this function is disabled.

Use txdelay 4, that is to say 40 ms tx/rx switching

The analog part of many modems needs a certain time to switch from Tx to Rx, due to coupling capacitors. Switching these modems to continuous Tx may be a good solution. *Siden T11 stopper MOD input ved Rx.*

### Voice and other applications :

Your T7F can be used for voice operation, providing some modifications : a mic-preamplifier (1 transistor), an AF amplifier (using an LM386 for example) for the loudspeaker. Control the squelch using the DCD signal connected outside, using X2. R53 is then used to adjust the squelch level.

No modification is need at 1200 Bauds. For higher speeds, you'll have to replace all IF filters with larger versions. Due to the bandwidth, sensitivity and selection of channels could be lowered

## Conclusion :

I7F can only be used for private use. You must ask the author before making any commercial use of the drawing. The author can not be responsible for any damages following the use of I7F.

This project meets the European EIS 300-684 norm for hamradio products, and the EMV EN 55022 norm. However, no official agreement has been done until now.

## Notes :

F1UNA indicates the following problems !

"I assembled a I7F and checked its performances on a spectral analyzer. To improve the transmitter, follow these hints :

- unsolder L16 pin next to C71 and add a 4/20 pF trimmer between both pins (L16 --- trimmer --- PCB)
- add a 33 Ohm resistor between ground and the R49 pin located next to T9
- finally, replace C35 with a 12 pF capacitor

Tune I7F one more time.

partlist :

Part	Value	Package
X C1	33p	C25
X C2	10n	C25
X C3	1uF	ELKO
X C4	47n	C5
X C5	10n	C25
X C6	1p5	C25
X C7	1n	C25
X C8	1n	C25
X C9	10n	C25
X C10	10uF	ELKO
X C11	4u7	ELKO
X C12	100p	C25
X C13	10n	C25
X C14	1p	C25
X C15	33p	C25
X C16	33p	C25
X C17	100p	C25
X C18	1p	C25
X C19	100uF	ELKO
X C20	33p	C25
X C21	0.1uF	C5
X C22	10uF	ELKO
X C23	10uF	ELKO
X C24	10n	C25
X C25	47n	C5
X C26	47n	C5
X C27	47n	C5
X C28	<del>5n6</del> 5p6	C25
X C29	10n	C25
X C30	3p3	C25
X C31	2p2	C25
X C32	33p	C25
X C33	47n	C5
X C34	100p	C25
X C35	100p → 12p (mod)	C25
X C36	10uF	ELKO
X C37	10n	C25
X C38	10uF	ELKO
X C39	10n	C25
X C40	10n	C25
X C41	3p3	C25
X C42	100p	C25
X C43	5p6	C25
X C44	5p6	C25
X C45	2p2	C25
X C46	100p	C25
X C47	2u2	ELKO
X C48	1n	C25
X C50	100p	C25
X C51	100p	C25
X C52	47n	C5
X C54	100p	C25
X C55	100p	C25
X C56	10uF	ELKO
X C57	100p	C25
X C58	47n	C5
X C59	<del>4p7</del> 5p6 <i>slip</i>	C25
X C60	100p	C25
X C61	1uF	ELKO
X C62	22p	C25
X C63	1uF	ELKO
X C64	100p	C25
X C65	100p	C25
X C66	47n	C5
X C67	10n	C25
X C68	10n	C25
X C69	100p	C25
X C70	30p	C25 red trim
X C71	5p6	C25

X C72	10p	C25
X C73	10μ	ELKO
X C74	47n	C5
X C75	.1uF	C5
X C76	8p2	C25
X C77	100p	C25
X C78	470p	C25
X C79	47n	C5
X D1	BB204	TO92
X D2	BB405	D5
X D3	1N4148	D7
X D4	BA479	D5
X D5	BA479	D5
X D8	BA479	D7
X D9	ZF5V1	ZD
X D10	BB204	TO92
X F11	21U15A	HC45U
X F12	CFUS450D	CFU
X IC1	PIC16F83	DIL18
X IC2	MB1504	DIL16
X IC3	MC3371	DIL16
X IC4	78L05	TO92
X L1	514630	HELIX
X L2	33uH	SP7
X L3	33uH	SP7
X L4	.33uH	SP7
X L5	3W3D	SP5
X L6	511765	HELIX
X L7	511765	HELIX
X L8	3.9uH	SP7
X L9	455kHz,sw	BANDFI
X L10	.33uH	SP10
X L11	3W3D	SP5
X L12	3W3D	SP5
X L13	.33uH	SP10
X L14	3.3uH	SP7
X L15	.33uH	SP10
X L16	.1uH	SP7
X L17	3W3D	SP5 → n.b (p2 print)
X L18	1uH	SP10
X PMOD	M67749M	PWR-MOD
X Q1	20.95MHz	HC49/U
X Q2	CSB1000	QS
X R1	100	R10
X R2	1M	R10
X R3	1M	R10
X R4	1M trimmer	R_IR_SI
X R5	680	R10
X R6	3k3	R10
X R7	10k	R10
X R8	4k7	R10
X R9	4k7	R10
X R10	10k	R10
X R11	3k3	R10
X R12	100k	R10
X R13	10k	R10
X R14	100	R10
X R15	10k	R10
X R16	15k	R10
X R17	100	R10
X R18	180	R10
X R19	47k	R10
X R20	100	R10
X R21	1k	R10
X R22	6k8	R10
X R23	2k7	R10
X R24	10k	R10
X R25	10k	R10
X R26	33k	R10
X R27	10k	R10

1.20  
n.b. (mod)

n.b.  
n.b.?


n.b. = nicht bestücken

102  
1000 PF = 1nF  
103  
10000 PF = 10nF  
  
473 = 47nF  
  
M10 = 0.1 nF  
= 100PF  
  
M47 = 0.47 nF = 470PF


*R28	4k7	R10
→ *R29	33 → 10.2k	R75
*R30	18k	R10
*R31	220	R10
*R32	82	R10
*R33	18k → 22k	R10
→ *R34	82	R10
*R35	10k	R10
*R36	470	R10
*R37	2k2	R10
*R38	2k2	R10
*R39	1k	R10
*R40	100	R10
*R41	25k trimmer	R_IR_ST
*R42	100k	R10
*R43	100	R10
*R44	150	R10
*R45	220	R10
→ *R46	18k	R10
*R47	470	R10
*R48	150	R10
*R49	39	R10
*R50	470	R10
*R51	470	R10
*R52	100	R10
*R53	100k trimmer	R_IR_ST
*R54	10k	R10

*R55	10k	R10
*R56	270	R10
*R57	10k	R10
*R58	100	R75
*R59	100	R10
*R60	330	R10
→ *R61	100	R10
*R62	2k2	R10
*R64	1M	R10
*T1	BC547	TO92
*T2	BC557	TO92
*T3	BFR91	SOT103
*T4	BC547	TO92
*T5	BF966	SOT103
*T6	BFR91	SOT103
*T7	<del>BER96</del> 372 91	SOT103
*T8	BD140	TO139
*T9	BFR91	SOT103
*T10	BFR91	SOT103
*T11	BS170	TO92
*T14	BC547	TO92
*T15	BF255	TO92
*T16	BC557	TO92
*T17	BS170	TO92
*X1	2X07/90	RM2 54
*X2	2X05/90	RM2 54

R63 100k  
T12 BC547  
T13 ?

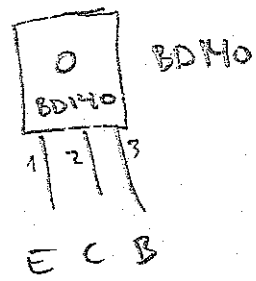

4 mm afstandstykker : PA-modul  
 5 " ——— " ——— : Print

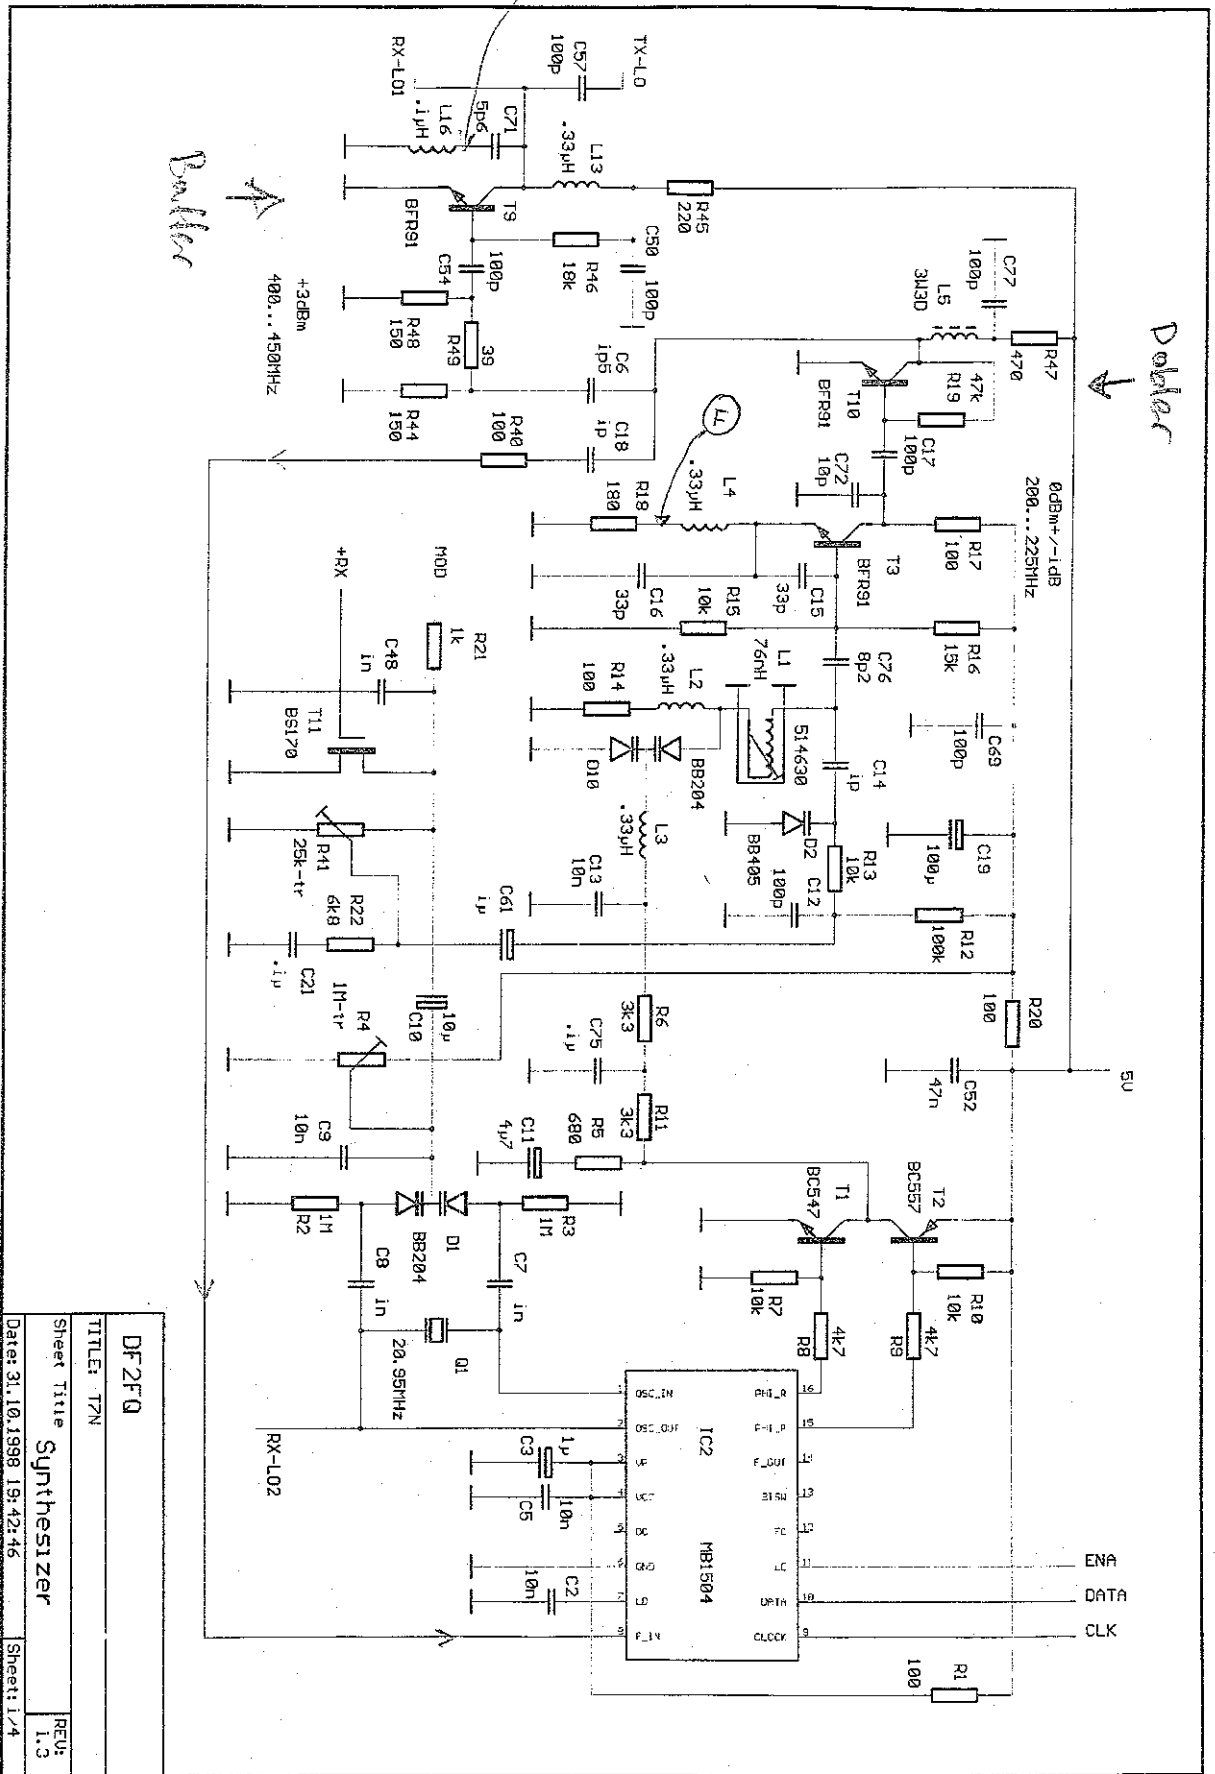

DF2F0	
TITLE: TZN	
Sheet Title	Synthesizer
Date: 31.10.1998 19:42:46	Sheet: 1/4
REU	L3

Bild 1


C12 10p

VAPC

$$f_c = \frac{1}{\sqrt{LC}}$$

$$f_c \Delta \Rightarrow f \Delta$$




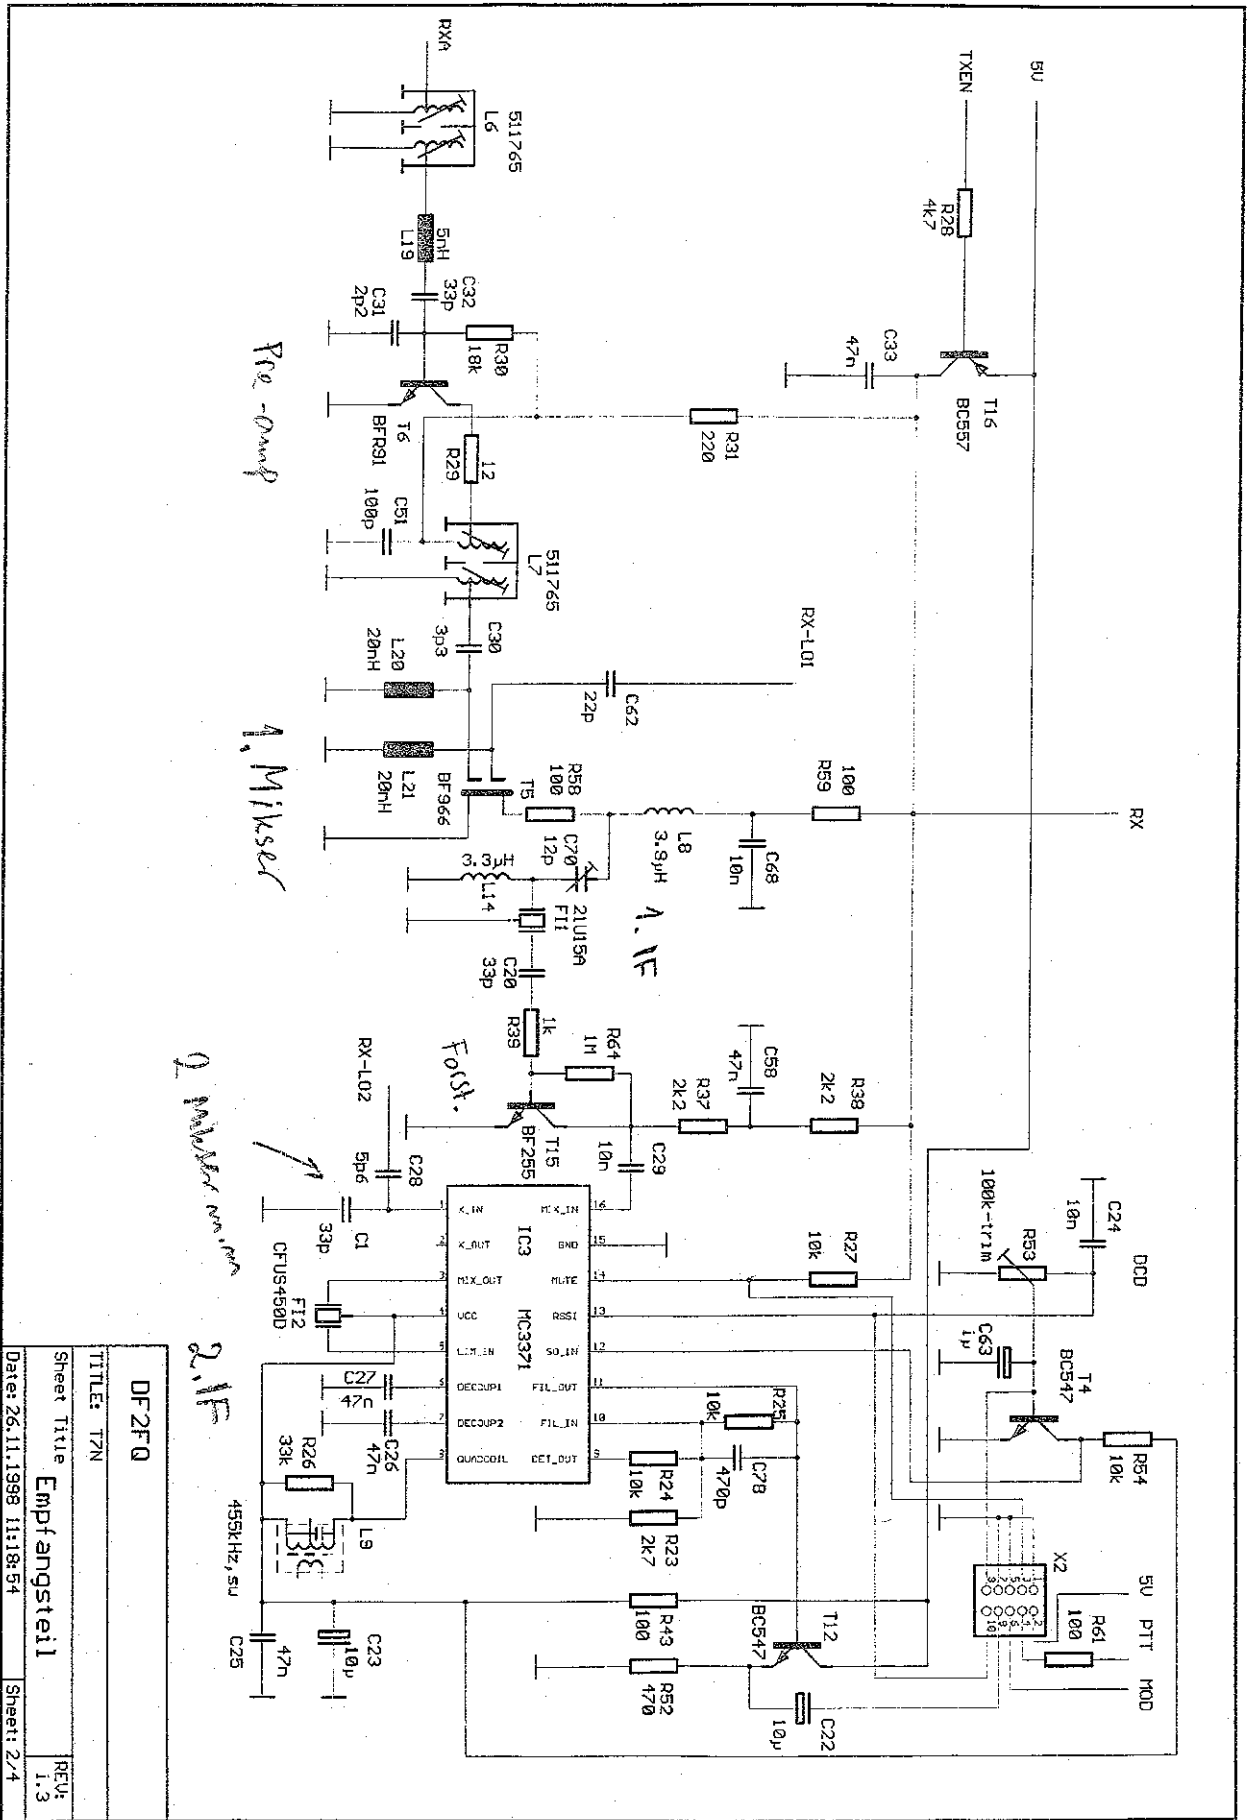

DF2F0  
 TITEL: T7N  
 Sheet Title: Empf. angsteil  
 Date: 26.11.1998 11:18:54  
 REV: 1.3  
 Sheet: 2/4


Bild 2

- |   |                   |    |                   |
|---|-------------------|----|-------------------|
| 1 | GND               | 2  | +5V               |
| 3 | MUTE P. 14 IC3 mm | 4  | PTT via 100Ω      |
| 5 | GND               | 6  | MOD               |
| 7 | GND               | 8  | AF out (via 100F) |
| 9 | DCD 1             | 10 | R551              |

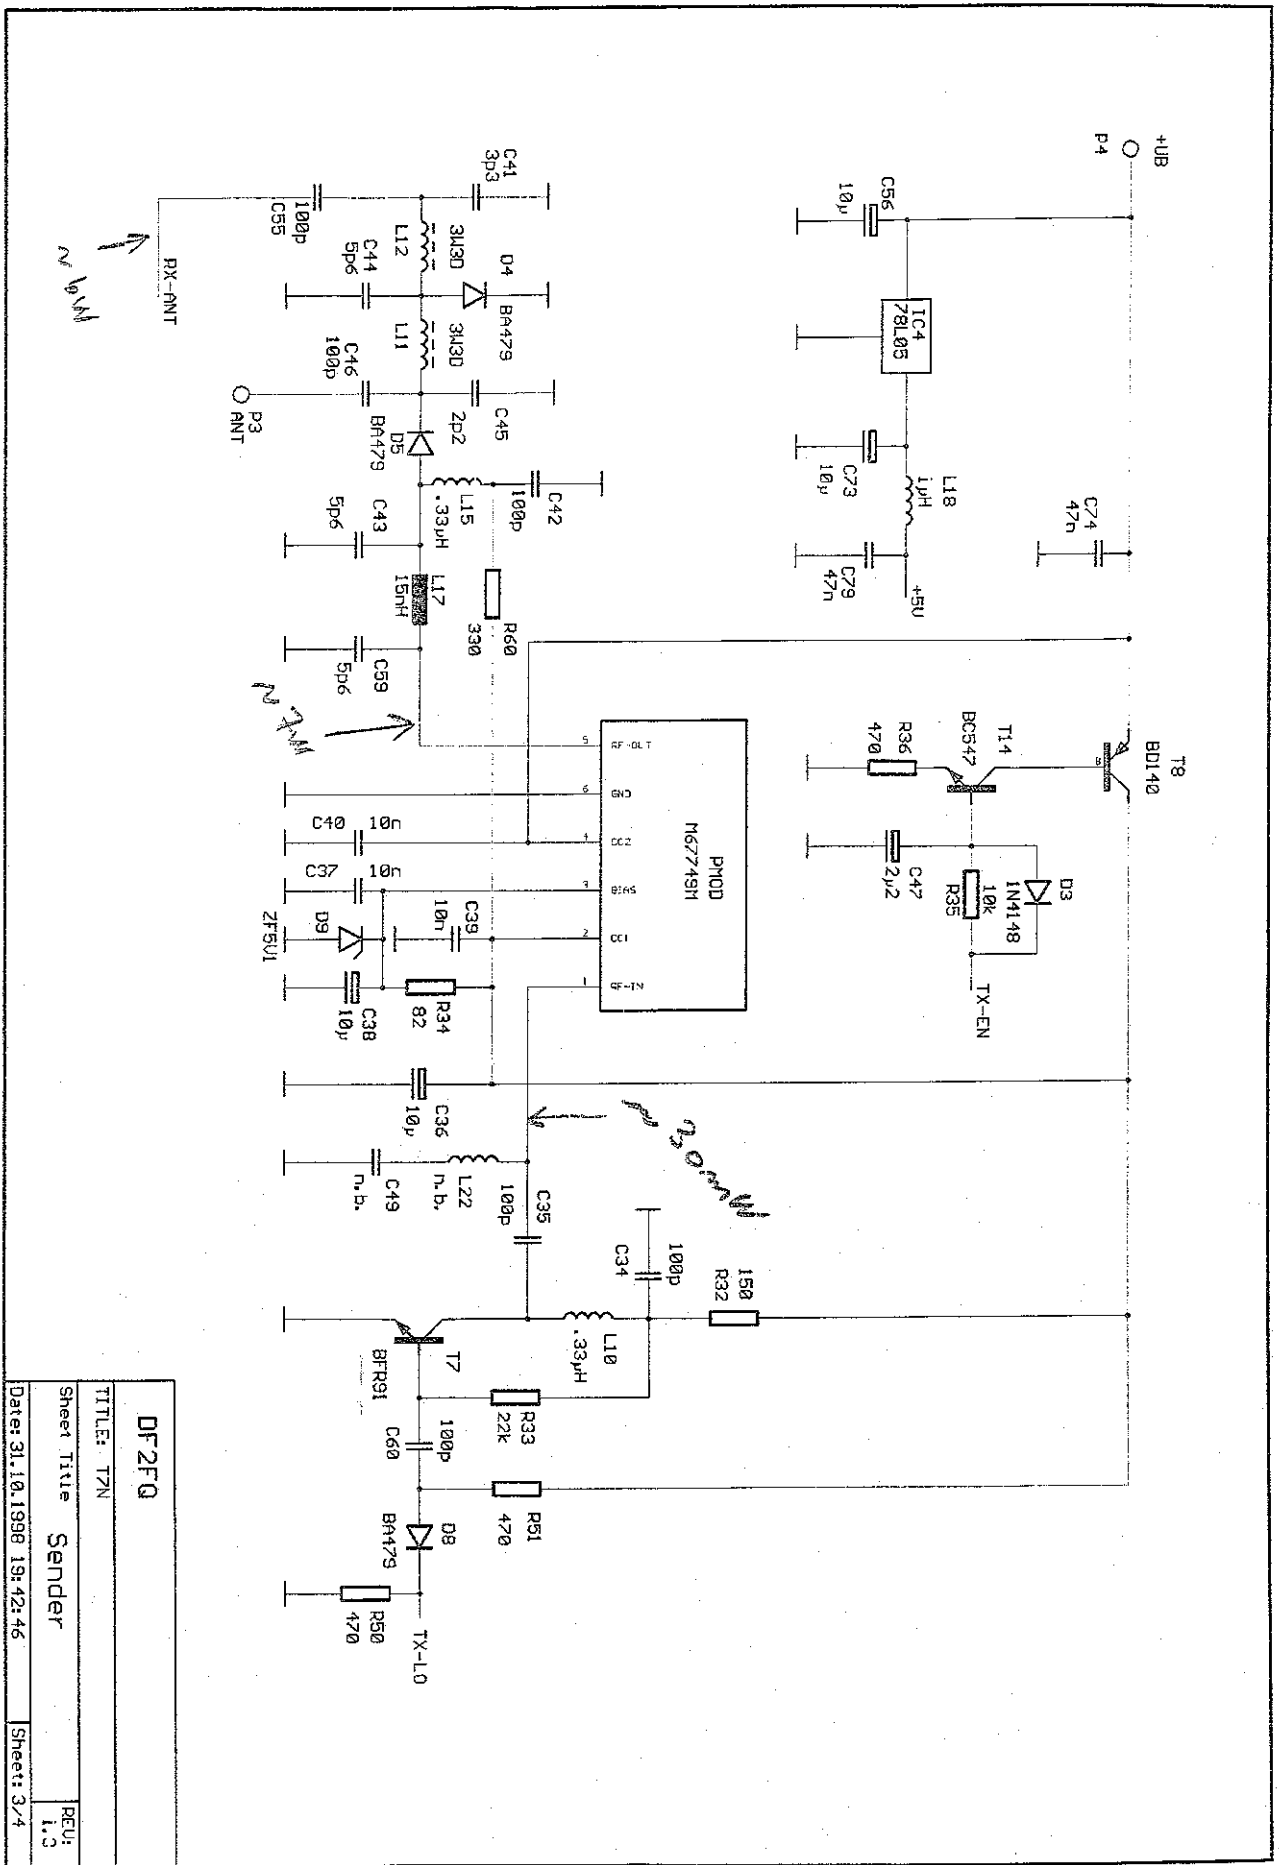

<b>DF2FQ</b>	
TITLE: TZN	
Sheet Title	Sender
Date: 31.10.1998 19:42:46	Sheet: 3/4
PEU	1,3

Bild 3

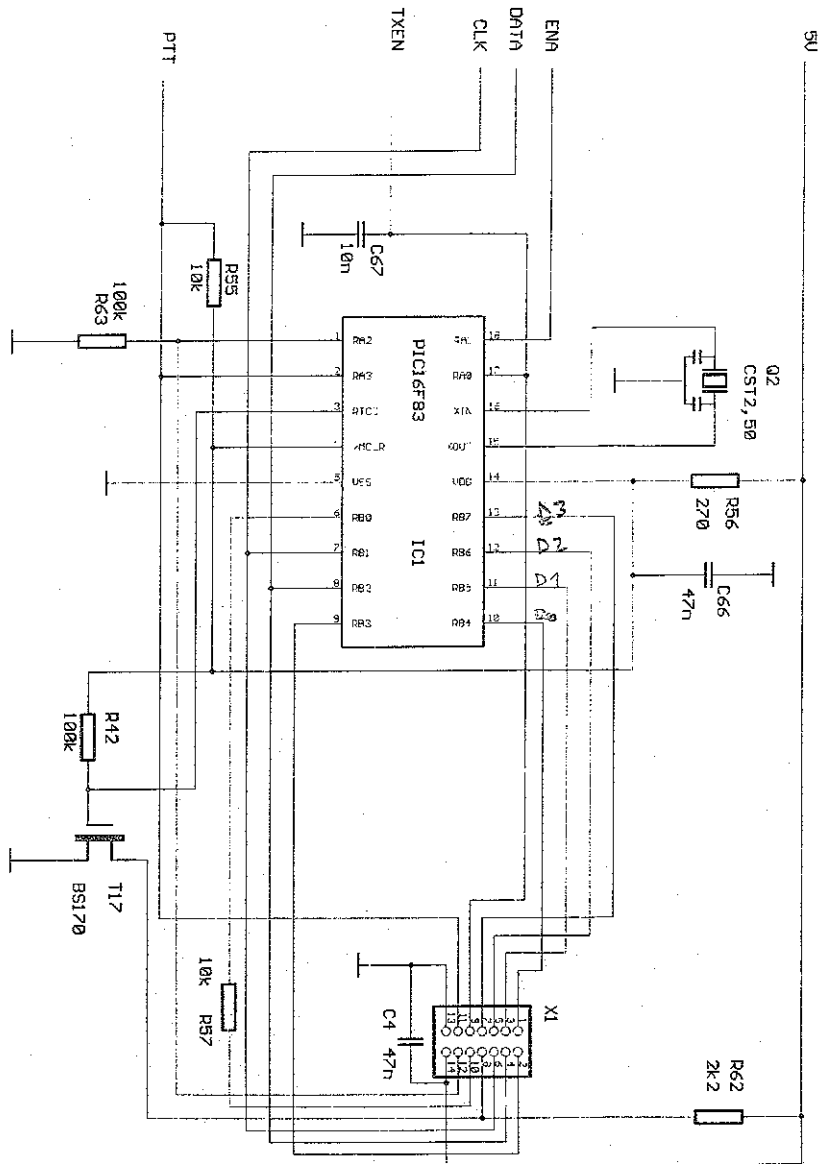


<b>DF2FQ</b>	
TITLE: TZN	
Sheet Title	Steuerung
Date: 31.10.1998 19:42:46	Sheet: 4/4
REV: 1.3	

Bild 4